





1st FLOOR PLAN PROPOSED SKETCH A
Scale: 1/8" = 1'-0"

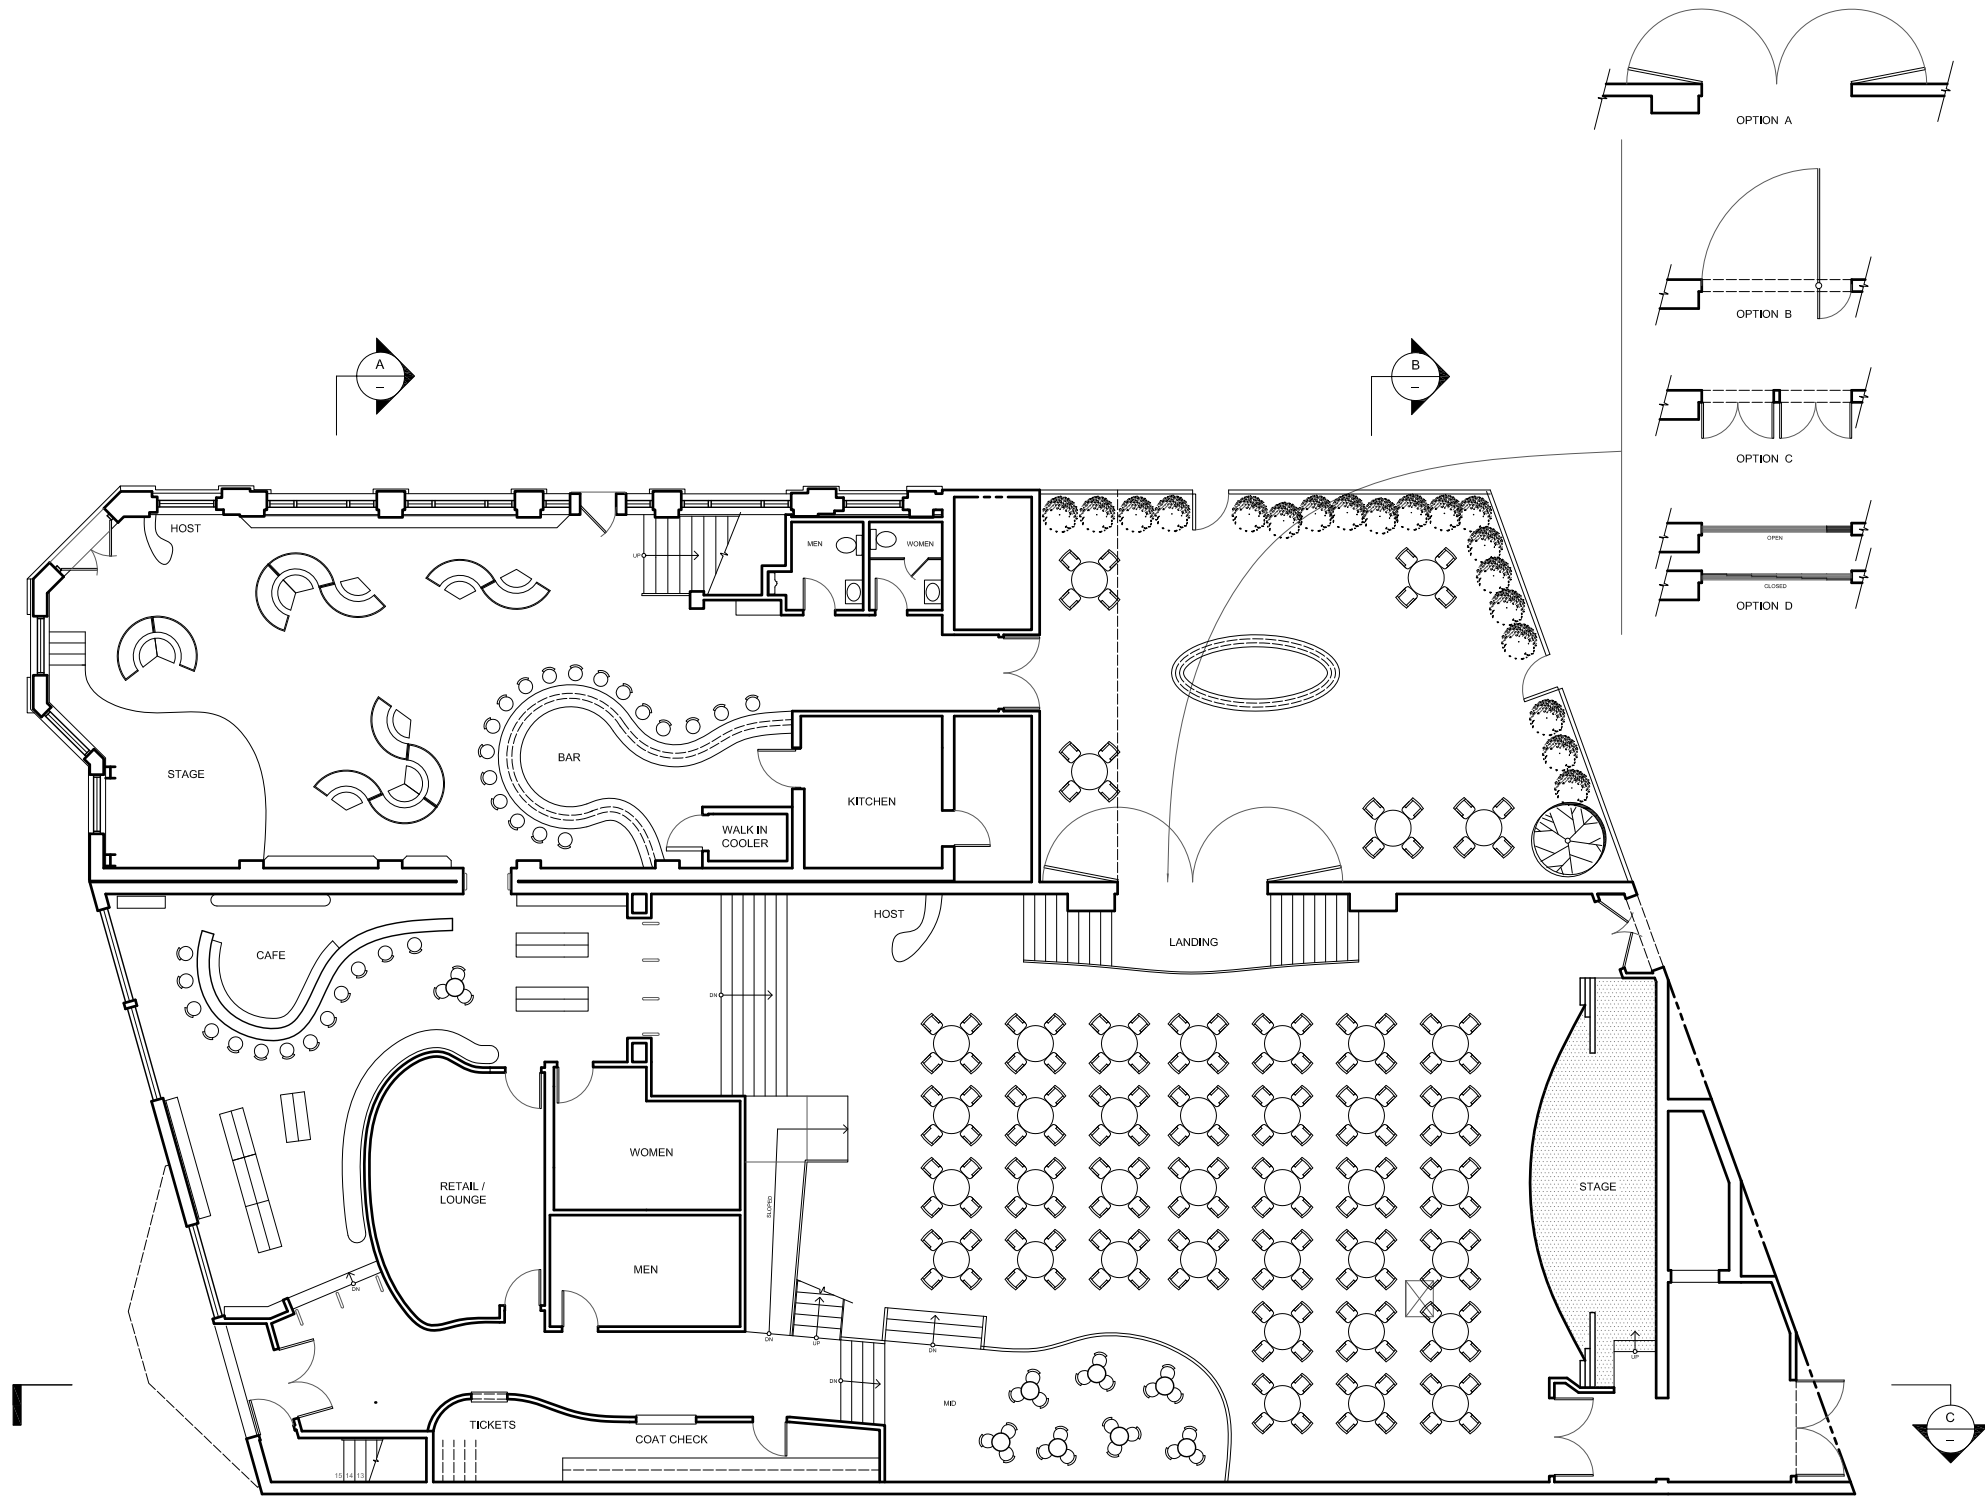


REVISIONS	
ALL LICENSE, PERMITS, AND PLANS INDICATED OR REFERENCED BY THIS DRAWING ARE OWNED BY AND THE PROPERTY OF STUDIO SLAB INC. AND WERE CREATED, EVOLVED, AND DEVELOPED FOR USE ON AND IN CONNECTION WITH THE PROJECT. ANY REUSE OR MODIFICATION OF THIS DRAWING WITHOUT THE WRITTEN PERMISSION OF STUDIO SLAB INC. SHALL BE USED BY OR DISCLOSED TO ANY PERSON, FIRM OR CORPORATION FOR ANY PURPOSE WHATSOEVER WITHOUT THE WRITTEN PERMISSION OF STUDIO SLAB INC. PRECEDENCE OVER SCALED DIMENSIONS. ALL CONTRACTORS AND SUBCONTRACTORS SHALL HAVE OBLIGATION TO VERIFY ALL DIMENSIONS AND CONDITIONS ON THE JOB, AND THIS OFFICE MUST BE NOTIFIED OF ANY VARIATIONS FROM THE DIMENSIONS AND CONDITIONS SHOWN BY THESE DRAWINGS.	
OWNER:	FAIS DO DO Steven J. Yablok 5257 W. Adams Blvd. Los Angeles, CA 90016 tel (323) 831-4636 x14 fax (323) 835-9989 steven@raisdodo.com
ARCHITECT:	STUDIO SLAB/INC. Martin Roy Mervel 1926 Echo Park Avenue Los Angeles, CA 90026 ph (323) 663-8833 cell (310) 279-3393 mervel@studioslab.com
OCTOBER 19, 2006	
FLOOR PLAN	
SK-A1	

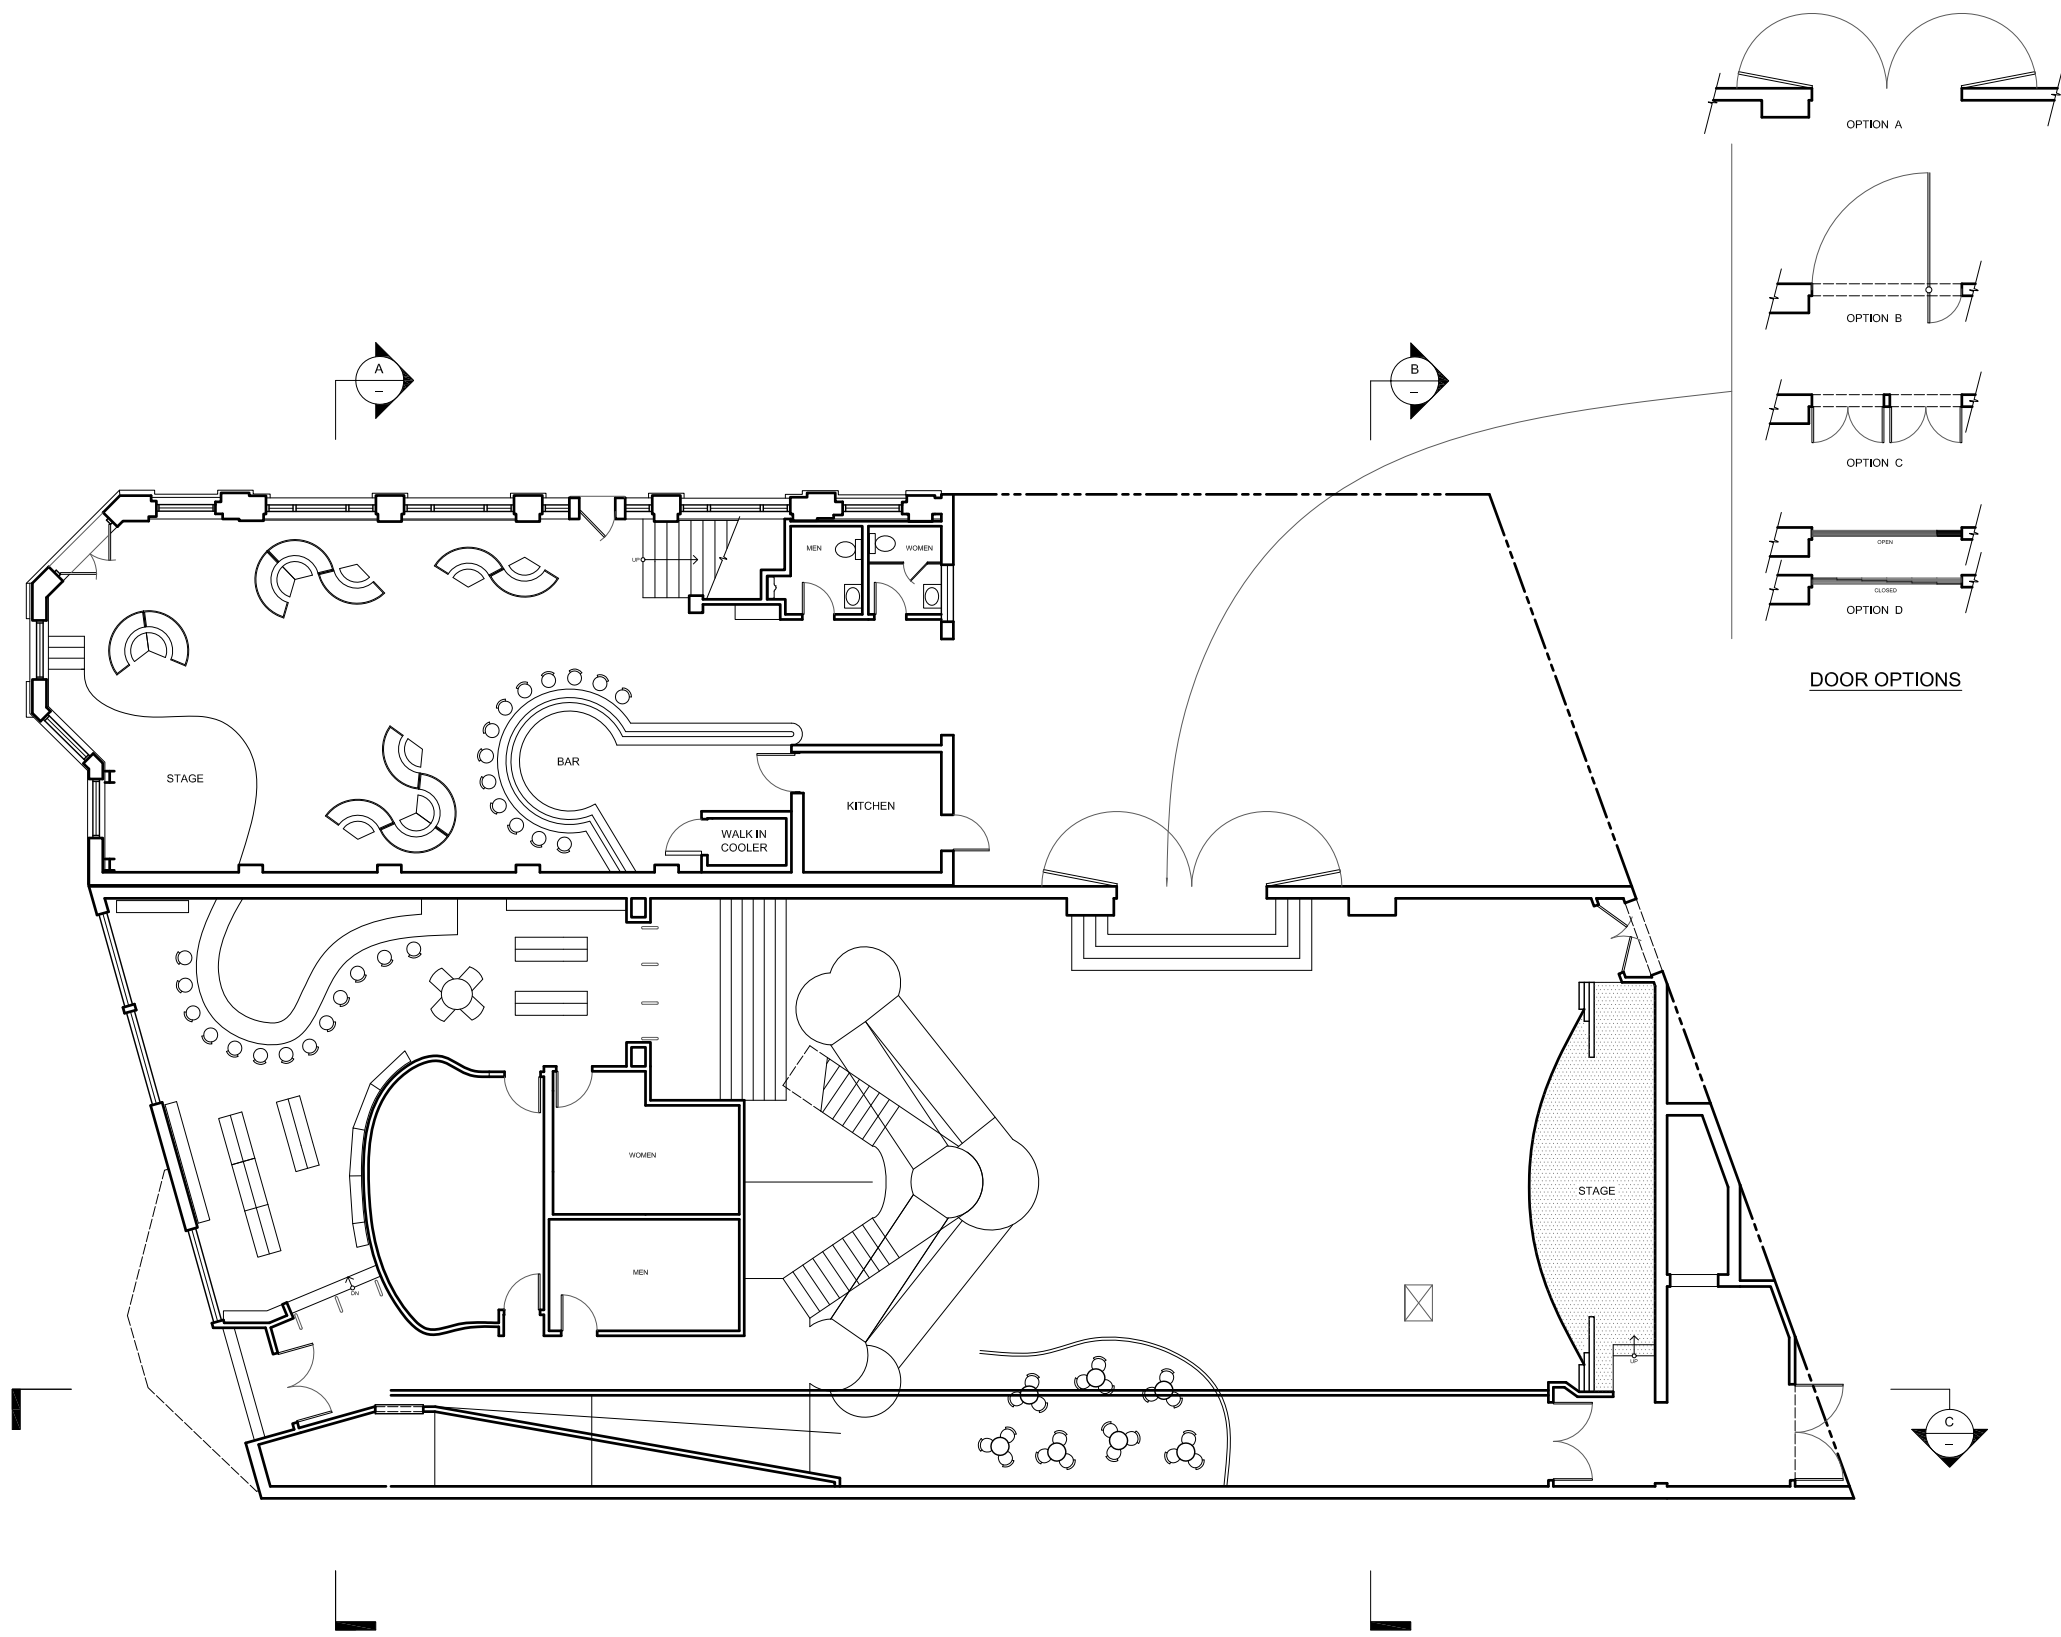

1st FLOOR PLAN PROPOSED SKETCH B
Scale: 1/8" = 1'-0"




REVISIONS	
ALL DESIGNS, ARRANGEMENTS AND PLANS INDICATED OR REPRESENTED BY THIS DRAWING SHALL BE THE PROPERTY OF STUDIO SLAB INC. AND SHALL REMAIN THE PROPERTY OF STUDIO SLAB INC. NO PART OF THIS DRAWING SHALL BE REPRODUCED, COPIED, OR TRANSMITTED IN ANY FORM OR BY ANY MEANS, ELECTRONIC OR MECHANICAL, INCLUDING PHOTOCOPYING, RECORDING, OR BY ANY INFORMATION STORAGE AND RETRIEVAL SYSTEM, WITHOUT THE WRITTEN PERMISSION OF STUDIO SLAB INC. SUBCONTRACTORS SHALL VERIFY AND BE RESPONSIBLE FOR ALL DIMENSIONS AND CONDITIONS SHOWN BY THESE DRAWINGS.	
OWNER:	FAIS DO DO Steven J. Yablouk 5257 W. Adams Blvd. Los Angeles, CA 90016 tel (323) 931-4636 x14 fax (323) 935-9989 stevenj@raisdodo.com
ARCHITECT:	STUDIO SLAB/INC. Martin Roy Mervel 1926 Echo Park Avenue Los Angeles, CA 90026 ph 323 663 8799 fax 323 663 8832 call 323 279 3383 mervel@studioslab.com
OCTOBER 19, 2006	
FLOOR PLAN	
SK-B1	

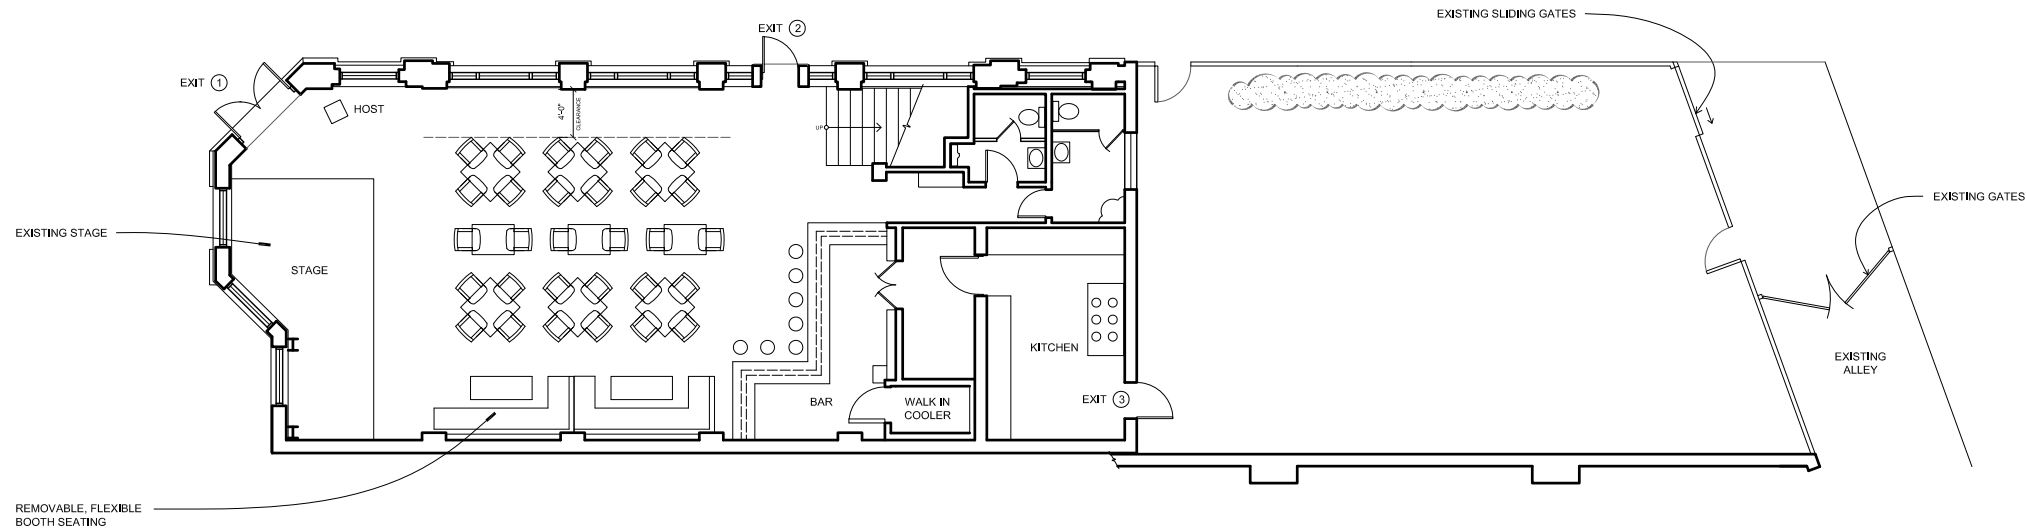

PRELIMINARY 5257 OCCUPANT SEATING PLAN DIAGRAM

Scale: 1/8" = 1'-0"


OPTION 1

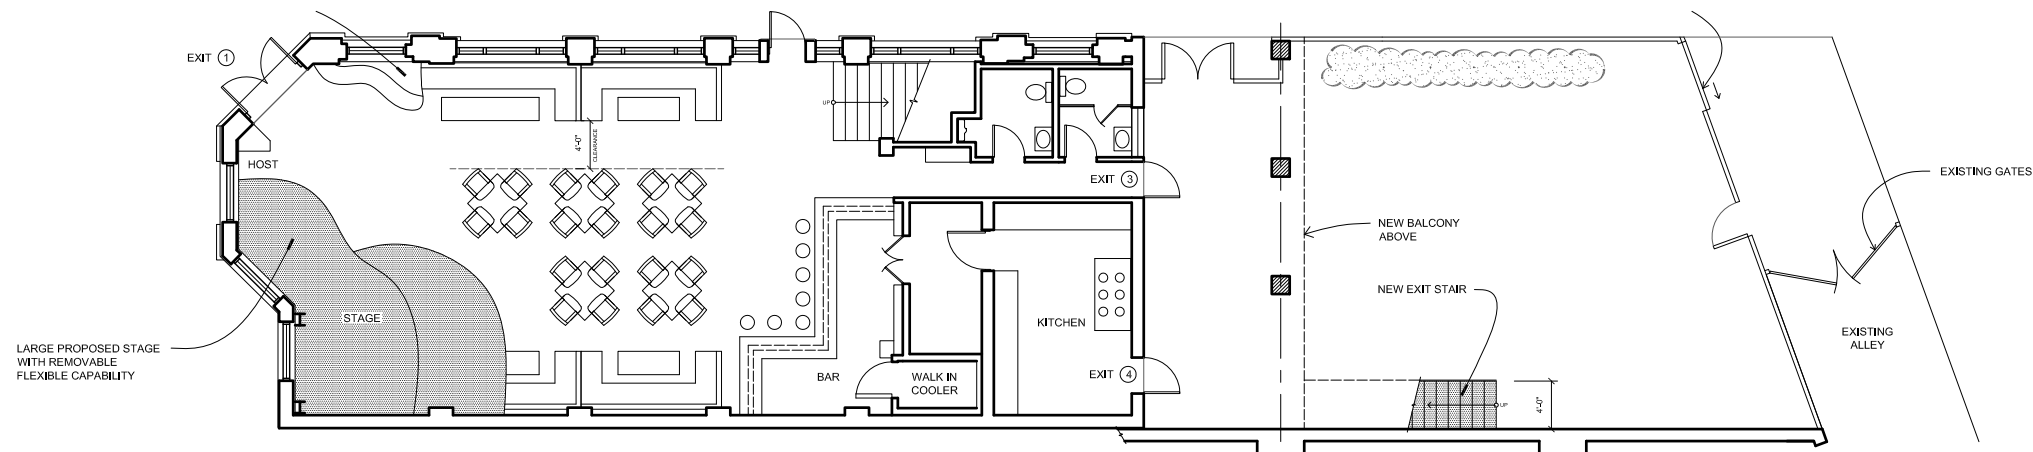

PRELIMINARY 5257 OCCUPANT SEATING PLAN DIAGRAM

Scale: 1/8" = 1'-0"

OPTION 2

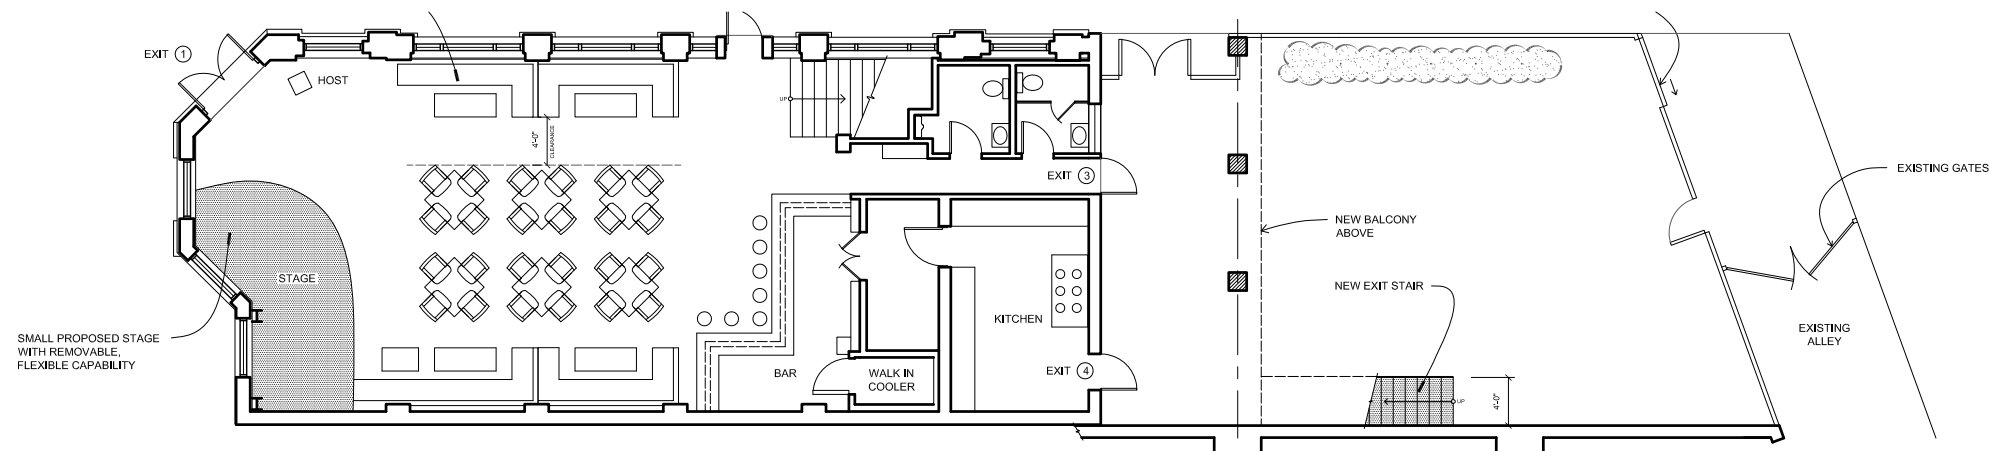

PRELIMINARY 5257 OCCUPANT SEATING PLAN DIAGRAM

Scale: 1/8" = 1'-0"

OPTION 3



REVISIONS

ALL DESIGNS, ARRANGEMENTS AND PLANS INDICATED OR REPRESENTED BY THIS DRAWING ARE THE PROPERTY OF STUDIO SLAB INC. AND ARE TO BE USED ONLY FOR THE SPECIFIED PROJECT. NONE OF SUCH IDEAS, DESIGNS, ARRANGEMENTS OR PLANS ARE TO BE REPRODUCED, COPIED, OR USED IN ANY MANNER WITHOUT THE WRITTEN PERMISSION OF STUDIO SLAB INC. ANY PURPOSE WHATSOEVER WITHOUT THE WRITTEN PERMISSION OF STUDIO SLAB INC. SUBCONTRACTORS SHALL VERIFY AND BE RESPONSIBLE FOR ALL DIMENSIONS AND CONDITIONS SHOWN IN THESE DRAWINGS.


OWNER:
FAIS DO, DO
Steven J. Yablok
5257 W. Adams Blvd.
Los Angeles, CA 90016
tel (323) 931-4636 x114
fax (323) 935-9989
steven@faisdodo.com

ARCHITECT:
STUDIO SLAB/INC.
Martin Roy Mervel
1926 Echo Park Avenue
Los Angeles, CA 90026
ph 323 663 8799
fax 323 663 8832
cell 310 279 3393
mervel@studioslab.com

OCTOBER 19, 2006


FLOOR PLAN OPTIONS

FD-1

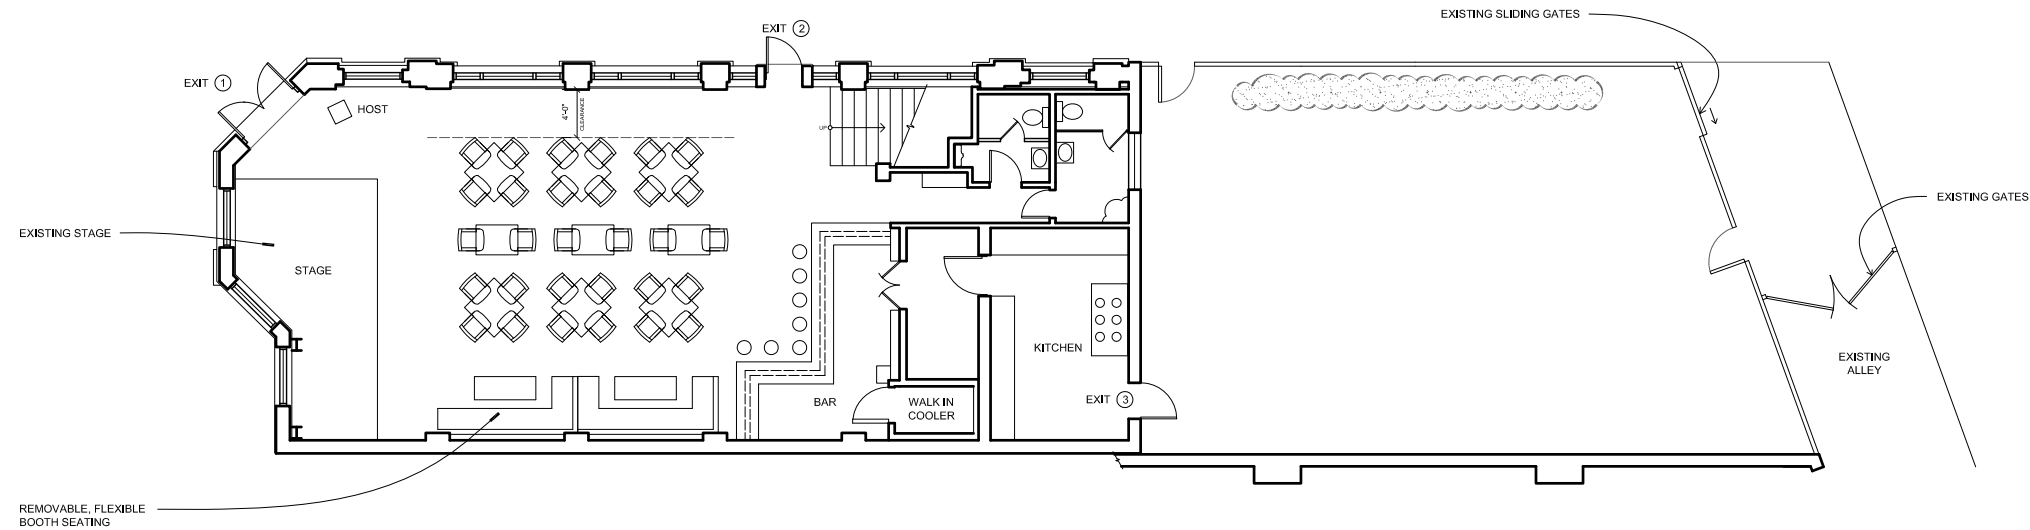

AS BUILT OCCUPANT SEATING PLAN DIAGRAM
Scale: 1/8" = 1'-0"

EXISTING AS BUILT CONDITION

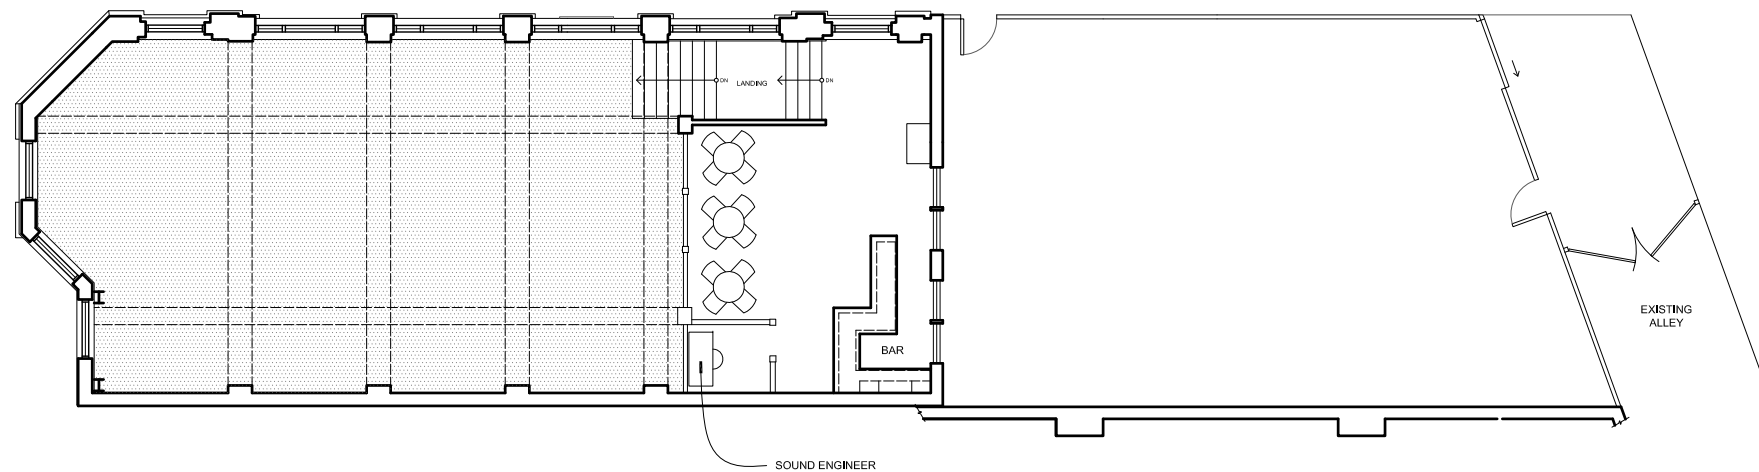

2nd FLOOR OCCUPANT SEATING PLAN DIAGRAM
Scale: 1/8" = 1'-0"

EXISTING AS BUILT CONDITION



REVISIONS	
ALL DESIGN, CONSTRUCTION, AND FINISHES ARE INDICATED OR REFERENCED BY THIS DRAWING. ANY CHANGES, ADDITIONS, OR DELETIONS TO THIS DRAWING SHALL BE MADE BY THE ARCHITECT. THIS DRAWING IS THE PROPERTY OF STUDIO SLAB INC. AND SHALL BE USED BY OR DISCLOSED TO ANY PERSON, FIRM OR CORPORATION FOR ANY PURPOSE WHATSOEVER WITHOUT THE WRITTEN PERMISSION OF STUDIO SLAB INC. THE ARCHITECT'S DESIGN SHALL HAVE PRECEDENCE OVER SCALED DIMENSIONS. ALL CONTRACTORS AND SUBCONTRACTORS SHALL BE RESPONSIBLE FOR VERIFYING ALL DIMENSIONS AND CONDITIONS ON THE JOB, AND THE PRICE MUST BE NOTIFIED OF ANY VARIATIONS FROM THE DIMENSIONS AND CONDITIONS SHOWN BY THESE DRAWINGS.	
OWNER:	FAIS DO DO Steven J. Yablok 5257 W. Adams Blvd. Los Angeles, CA 90016 tel (323) 831-4636 x14 fax (323) 835-9989 steven@raisdodo.com
ARCHITECT:	STUDIO SLAB/INC. Martin Roy Mervel 1926 Echo Park Avenue Los Angeles, CA 90026 ph (323) 863-8830 cell (310) 279-3393 mervel@studioslab.com
OCTOBER 19, 2006	
AS BUILT	
FLOOR PLAN	
FD-1	



EXISTING CONSTRUCTION TO REMAIN 

NEW CONSTRUCTION



ALL DESIGNS, ARRANGEMENTS AND PLANS INDICATED OR REPRESENTED BY THIS DRAWING ARE OWNED BY AND THE PROPERTY OF **STUDIO SLAB INC.** AND WERE CREATED, EVOLVED, AND DEVELOPED FOR USE ON AND IN CONNECTION WITH THIS PROJECT. ANY REUSE, REPRODUCTION, OR MODIFICATION OF THESE DRAWINGS SHALL BE USED BY OR DISCLOSED TO ANY PERSON, FIRM OR CORPORATION FOR ANY PURPOSE WHATSOEVER WITHOUT THE WRITTEN PERMISSION OF **STUDIO SLAB INC.** WRITTEN PERMISSIONS OF THESE DRAWINGS SHALL HAVE SUBCONTRACTORS SHALL VERIFY AND BE RESPONSIBLE FOR ALL DIMENSIONS AND CONDITIONS ON THE JOB. AND THIS OFFICE MUST BE NOTIFIED OF ANY VARIATIONS FROM THE DIMENSIONS AND CONDITIONS SHOWN BY THESE DRAWINGS.

OWNER:
FAIS DO. DO
Steven J. Yablok
5257 W. Adams Blvd.
Los Angeles, CA 90016
tel (323) 931-4636 x14
fax (323) 935-9989
steven@faisdodo.com


ARCHITECT:
STUDIO SLAB/INC.
Martin Roy Mervel
1926 Echo Park Avenue
Los Angeles, CA 90026

ph 323 663 8799
fax 323 663 8832
cell 310 279 3393
mervel@studioslab.com

OCTOBER 19, 2006

PROPOSED


FLOOR PLAN

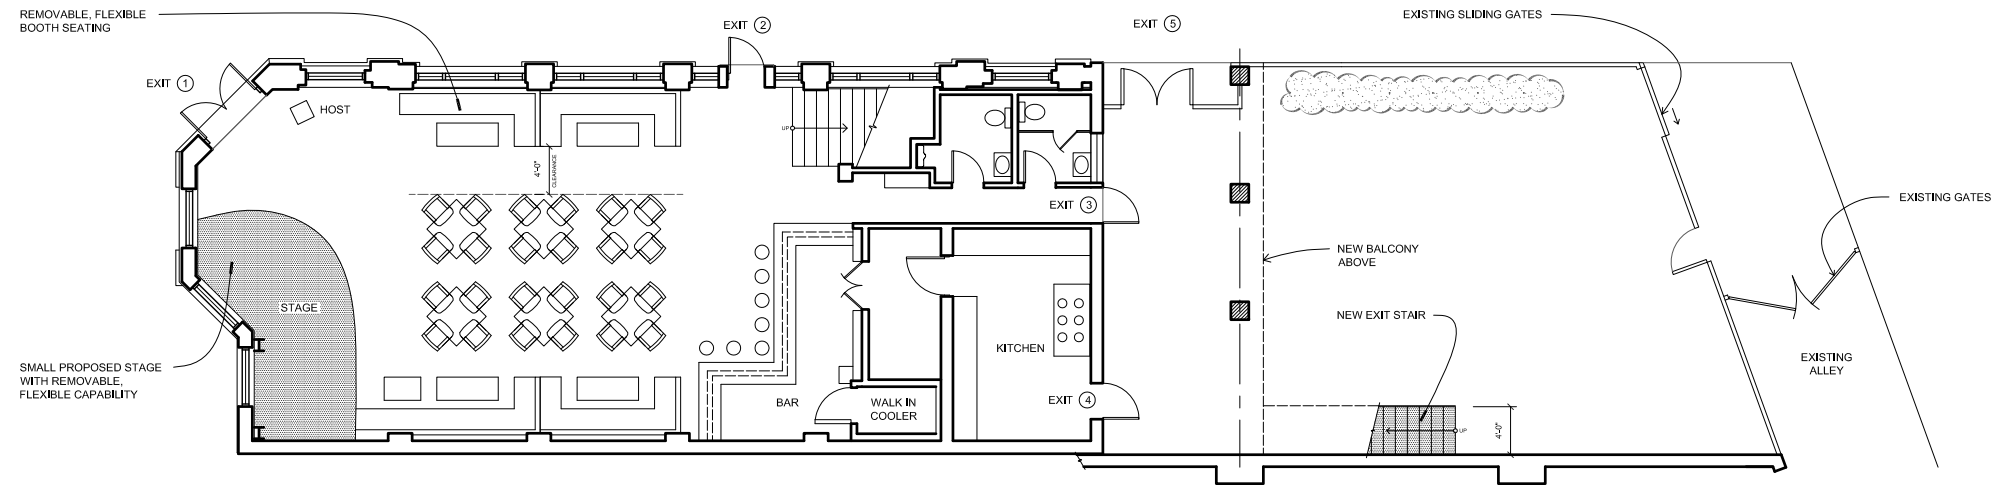

1st FLOOR PRELIMINARY OCCUPANT SEATING PLAN DIAGRAM

OPTION B

Scale: 1/8" = 1'-0"

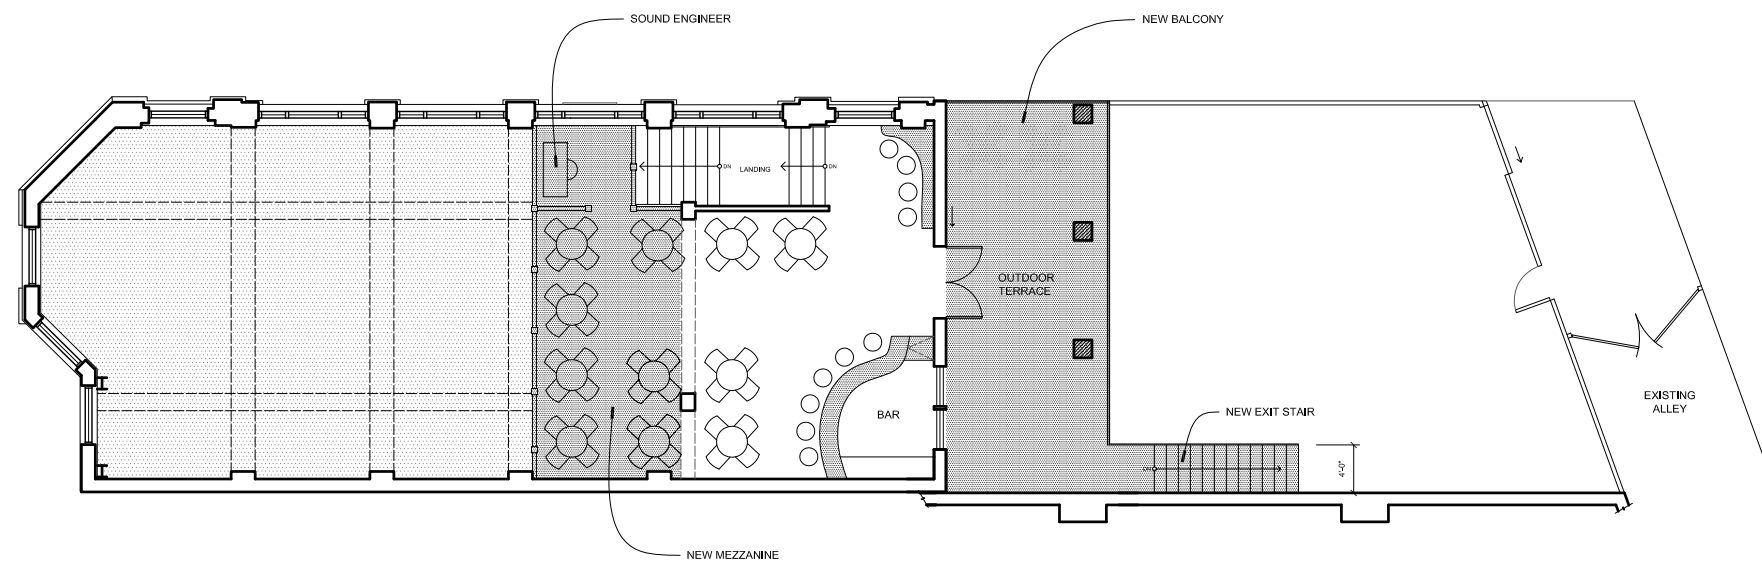

2nd FLOOR PRELIMINARY OCCUPANT SEATING PLAN DIAGRAM

OPTION B


Scale: 1/8" = 1'-0"

LEGEND


EXISTING CONSTRUCTION TO REMAIN
NEW CONSTRUCTION



REVISIONS	
ALL DESIGNS, ARRANGEMENTS AND PLANS INDICATED OR REPRESENTED BY THIS DRAWING ARE THE PROPERTY OF FAIS DO DO. NO PART OF THIS DRAWING SHALL BE REPRODUCED, COPIED, OR TRANSMITTED IN ANY FORM OR BY ANY MEANS, WITHOUT THE WRITTEN PERMISSION OF FAIS DO DO. ANY REUSE OF THIS DRAWING FOR ANY OTHER PROJECT WITHOUT THE WRITTEN PERMISSION OF FAIS DO DO IS STRICTLY PROHIBITED. SUBCONTRACTORS SHALL VERIFY AND BE RESPONSIBLE FOR ALL DIMENSIONS AND CONDITIONS SHOWN BY THESE DRAWINGS.	
OWNER:	FAIS DO DO Steven J. Yablouk 5257 W. Adams Blvd. Los Angeles, CA 90016 tel (323) 931-4636 x14 fax (323) 935-9989 stevenj@faisdodo.com
ARCHITECT:	STUDIO SLAB/INC. Martin Roy Mervel 1926 Echo Park Avenue Los Angeles, CA 90026 ph 323 663 8799 fax 323 663 8832 cell 310 279 3393 mervel@studioslab.com
DATE:	OCTOBER 19, 2006
	PROPOSED
	FLOOR PLAN
	FD-3

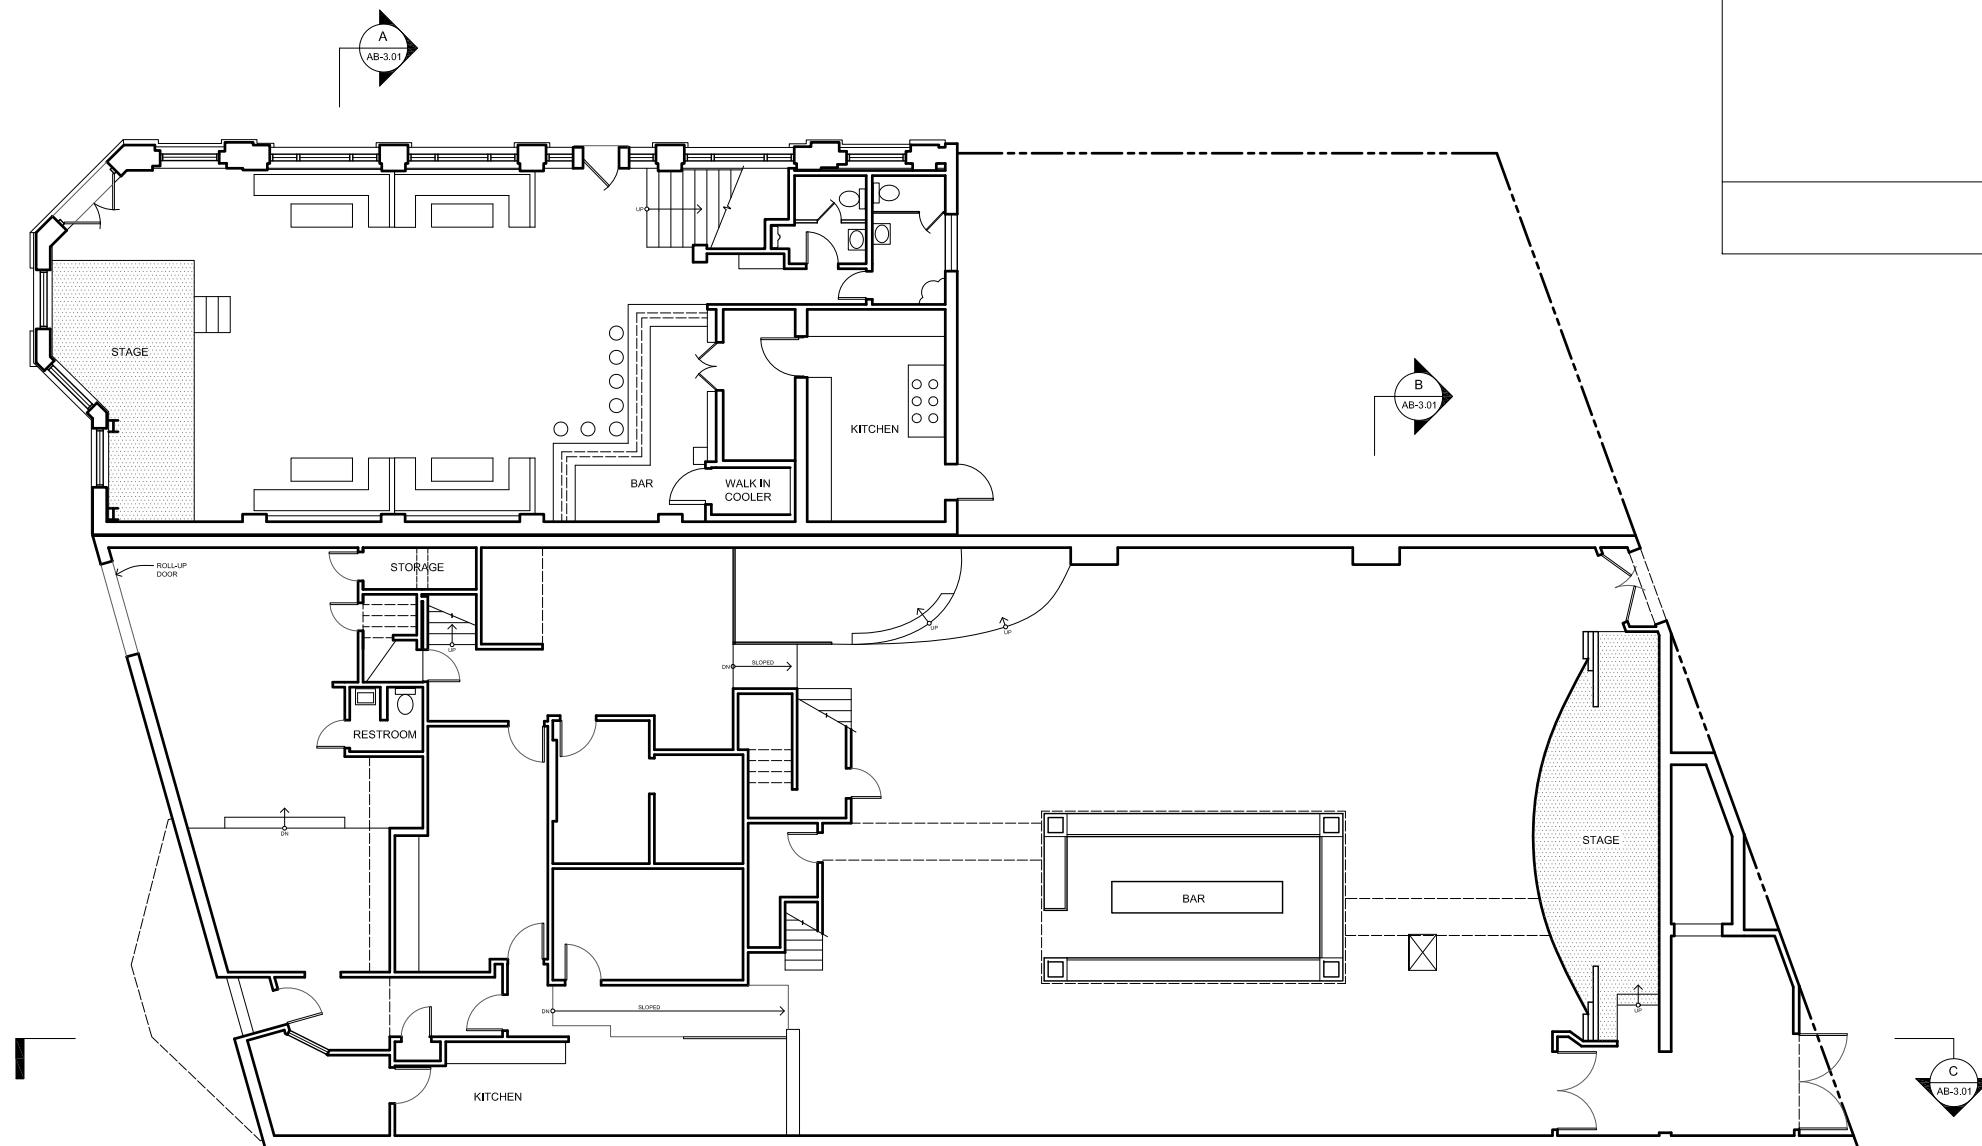

1st FLOOR PLAN EXISTING
Scale: 1/8" = 1'-0"

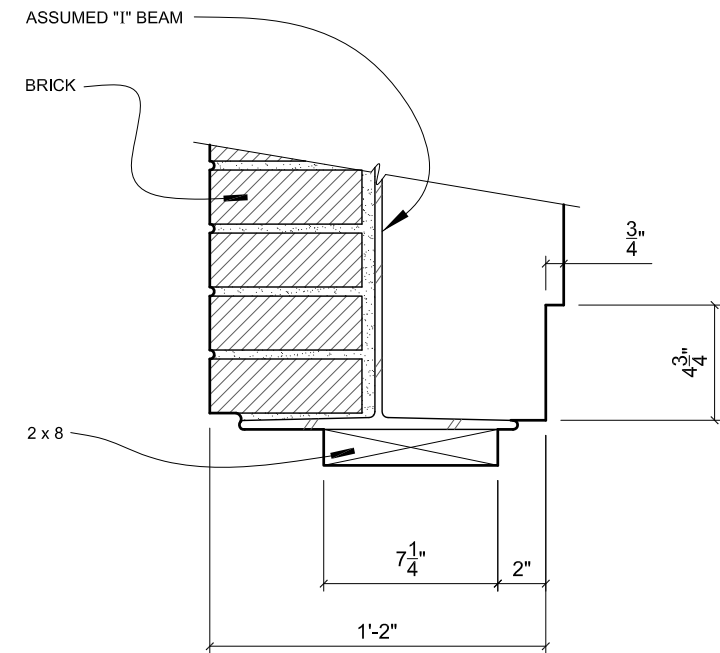


HEADER
Scale: 3" = 1'-0"

A



REVISIONS	
ALL DESIGN, CONSTRUCTION, AND INSTALLATION DETAILS ARE THE PROPERTY OF STUDIO SLAB INC. AND WERE CREATED, EVOLVED, AND DEVELOPED FOR USE ON AND IN CONNECTION WITH THE PROJECT. ANY REUSE OR MODIFICATION OF THESE DETAILS WITHOUT THE WRITTEN PERMISSION OF STUDIO SLAB INC. SHALL BE USED BY OR DISCLOSED TO ANY PERSON, FIRM OR CORPORATION FOR ANY PURPOSE WHATSOEVER WITHOUT THE WRITTEN PERMISSION OF STUDIO SLAB INC. PRECEDENCE OVER SCALED DIMENSIONS. ALL CONTRACTORS AND SUBCONTRACTORS SHALL HAVE OBLIGATION TO VERIFY ALL DIMENSIONS AND CONDITIONS ON THE JOB, AND THIS OFFICE MUST BE NOTIFIED OF ANY VARIATIONS FROM THE DIMENSIONS AND CONDITIONS SHOWN BY THESE DRAWINGS.	
OWNER:	FAIS DO DO Steven J. Yablok 5257 W. Adams Blvd. Los Angeles, CA 90016 tel (323) 831-4636 x14 fax (323) 835-9989 steven@faisdodo.com
ARCHITECT:	STUDIO SLAB/INC. Martin Roy Mervel 1926 Echo Park Avenue Los Angeles, CA 90026 ph (323) 663-8833 cell (310) 279-3393 mervel@studioslab.com
OCTOBER 19, 2006	
AS BUILT	
FLOOR PLAN	
AB-1.01	

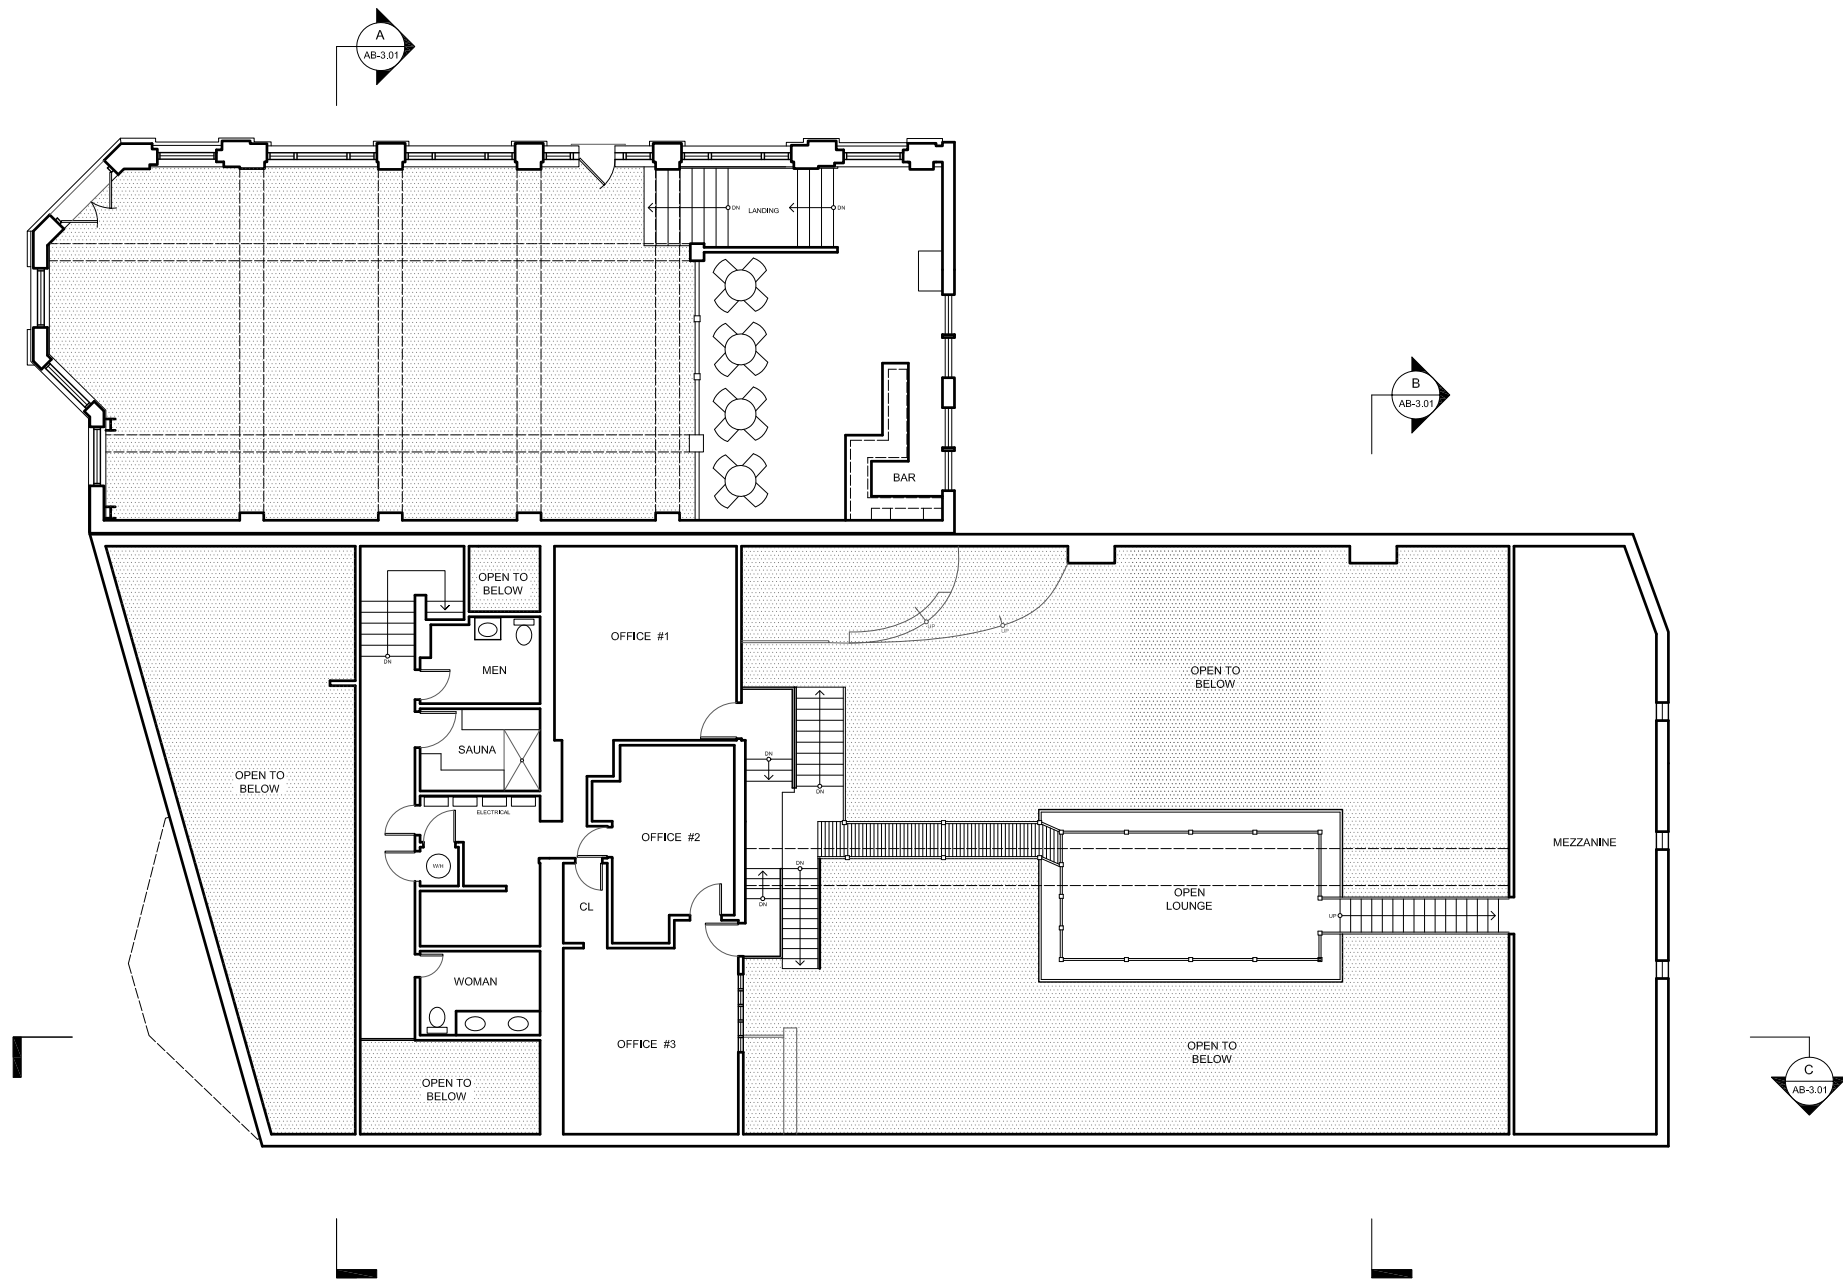

2nd FLOOR PLAN EXISTING
 Scale: 1/8" = 1'-0"




ARCHITECT:
STUDIO SLAB/INC.
 Martin Roy Mervel
 1926 Echo Park Avenue
 Los Angeles, CA 90026
 ph 323 663 8799
 fax 323 993 8832
 mervel@studioslab.com

OWNER:
FAIS DO DO
 Steven J. Yablok
 5257 W. Adams Blvd.
 Los Angeles, CA 90016
 tel (323) 931-4636 x14
 fax (323) 935-9989
 steven@faisdodo.com

OCTOBER 19, 2006
 AS BUILT
 FLOOR PLAN

AB-1.02


ALL DESIGNS, ARRANGEMENTS AND PLANS INDICATED OR REPRESENTED BY THIS DRAWING ARE THE PROPERTY OF STUDIO SLAB/INC. AND ARE NOT TO BE REPRODUCED, COPIED, OR USED IN ANY MANNER WITHOUT THE WRITTEN PERMISSION OF STUDIO SLAB/INC. ANY REUSE OR MODIFICATION OF THIS DRAWING WITHOUT THE WRITTEN PERMISSION OF STUDIO SLAB/INC. SHALL BE AT THE USER'S SOLE RISK AND WITHOUT LIABILITY TO STUDIO SLAB/INC. SUBCONTRACTORS SHALL VERIFY AND BE RESPONSIBLE FOR ALL DIMENSIONS AND CONDITIONS SHOWN BY THESE DRAWINGS.

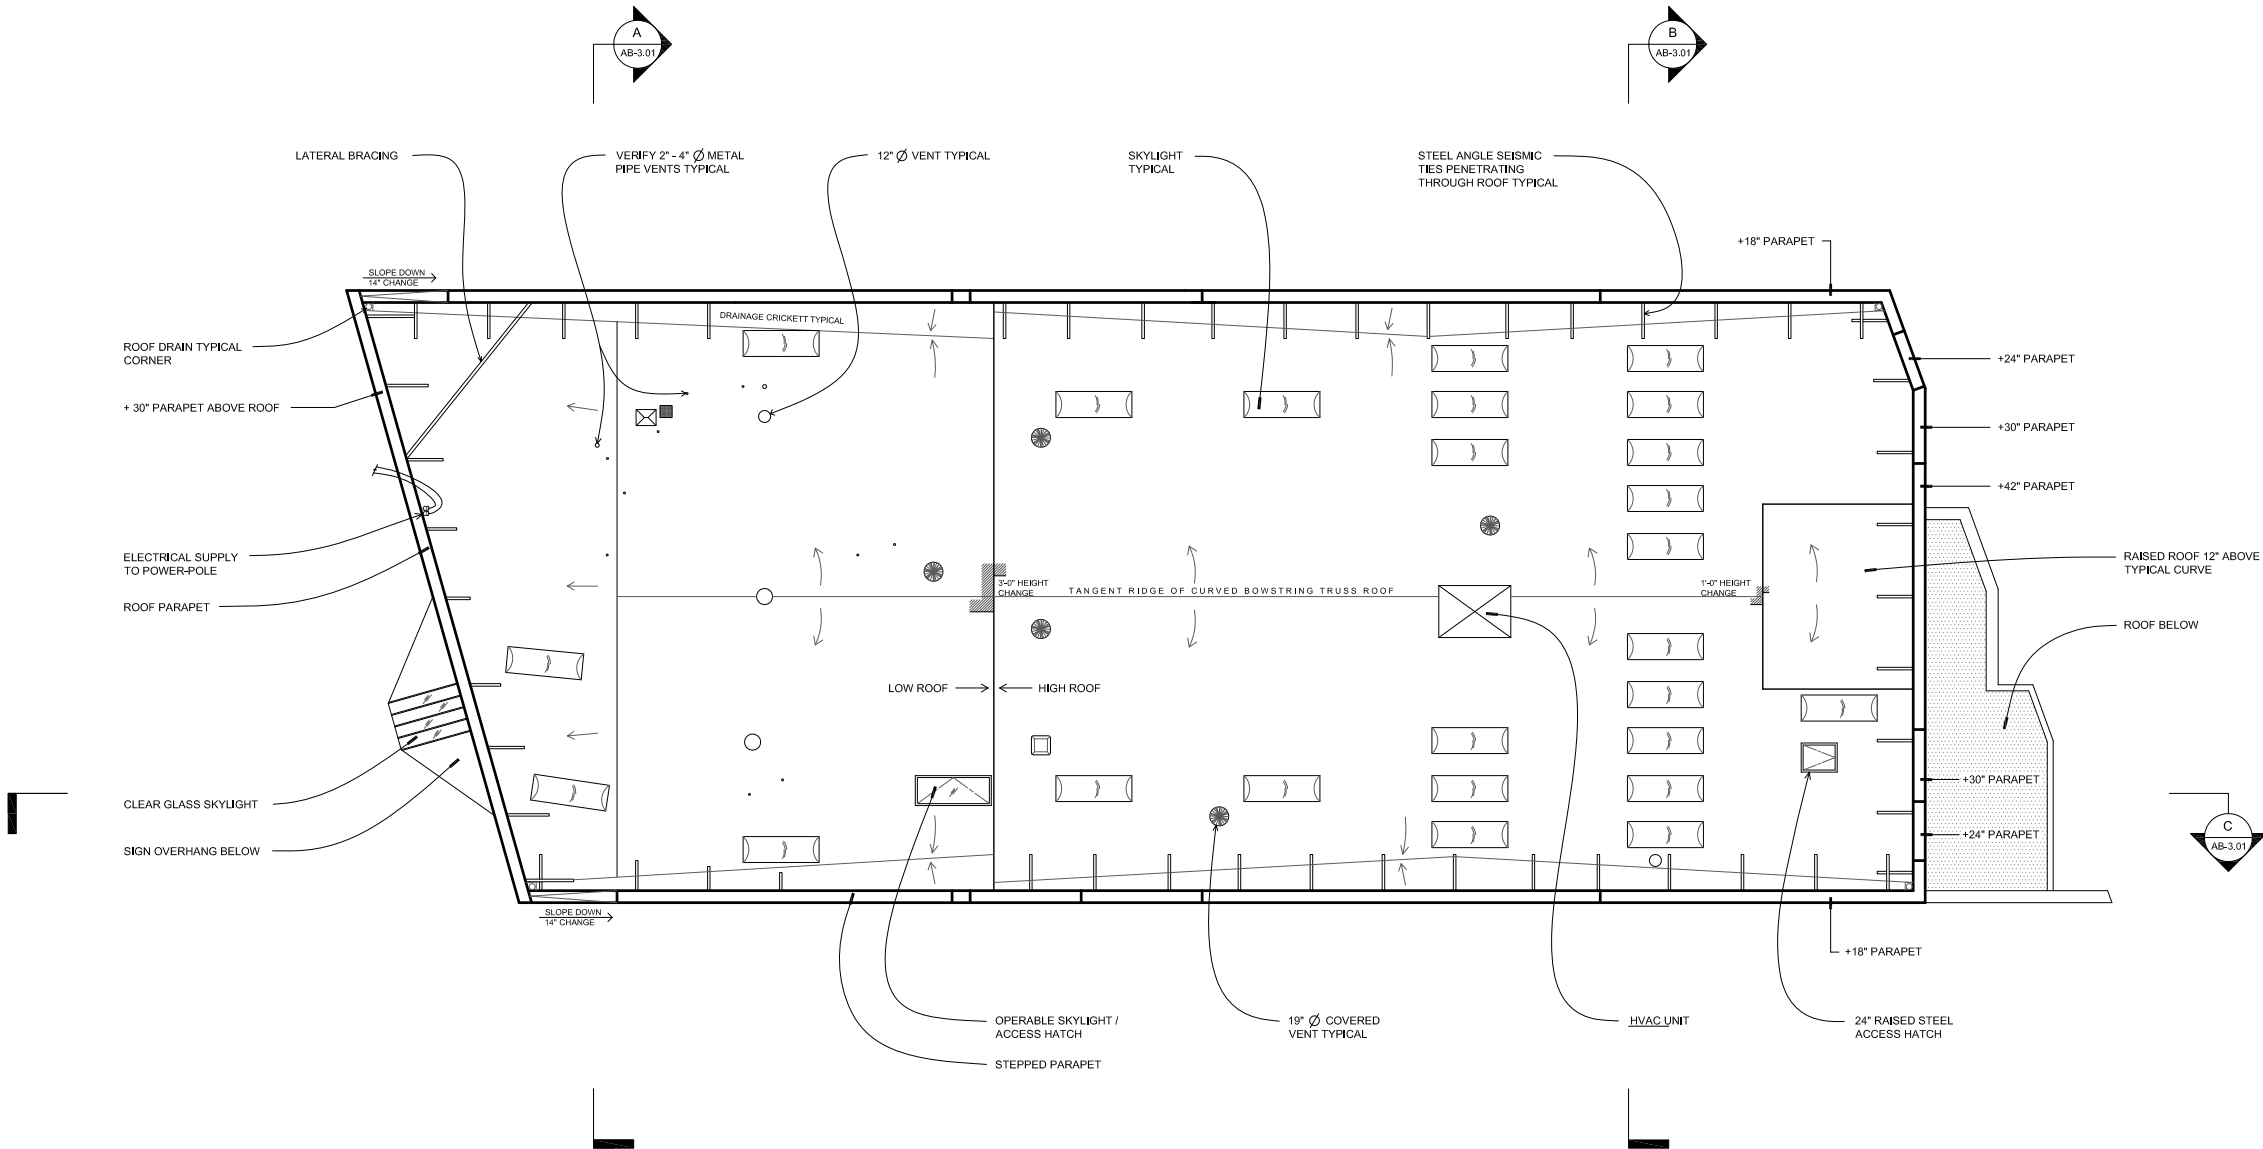

ROOF PLAN
Scale: 1/8" = 1'-0"




REVISIONS	
ALL DESIGNS, ARRANGEMENTS AND PLANS INDICATED OR REPRESENTED BY THIS DRAWING ARE THE PROPERTY OF FAIS DO DO. NO PART OF THIS DRAWING SHALL BE REPRODUCED, COPIED, OR TRANSMITTED IN ANY FORM OR BY ANY MEANS, ELECTRONIC OR MECHANICAL, INCLUDING PHOTOCOPYING, RECORDING, OR BY ANY INFORMATION STORAGE AND RETRIEVAL SYSTEM, WITHOUT THE WRITTEN PERMISSION OF FAIS DO DO. ANY UNAUTHORIZED USE OF THIS DRAWING SHALL BE CONSIDERED A VIOLATION OF THE COPYRIGHT LAWS OF THE UNITED STATES OF AMERICA. SUBCONTRACTORS SHALL VERIFY AND BE RESPONSIBLE FOR ALL DIMENSIONS AND CONDITIONS SHOWN BY THESE DRAWINGS. VARIATIONS FROM THE DIMENSIONS AND CONDITIONS SHOWN BY THESE DRAWINGS SHALL BE THE RESPONSIBILITY OF THE CONTRACTOR.	
OWNER:	FAIS DO DO Steven J. Yablok 5257 W. Adams Blvd. Los Angeles, CA 90016 tel (323) 931-4636 x14 fax (323) 935-9989 steven@faisdodo.com
ARCHITECT:	STUDIO SLAB/INC. Martin Roy Mervel 1926 Echo Park Avenue Los Angeles, CA 90026 ph 323 663 8799 fax 323 663 5333 mervel@studioslab.com
OCTOBER 19, 2006	
AS BUILT	
ROOF PLAN	
AB-1.03	

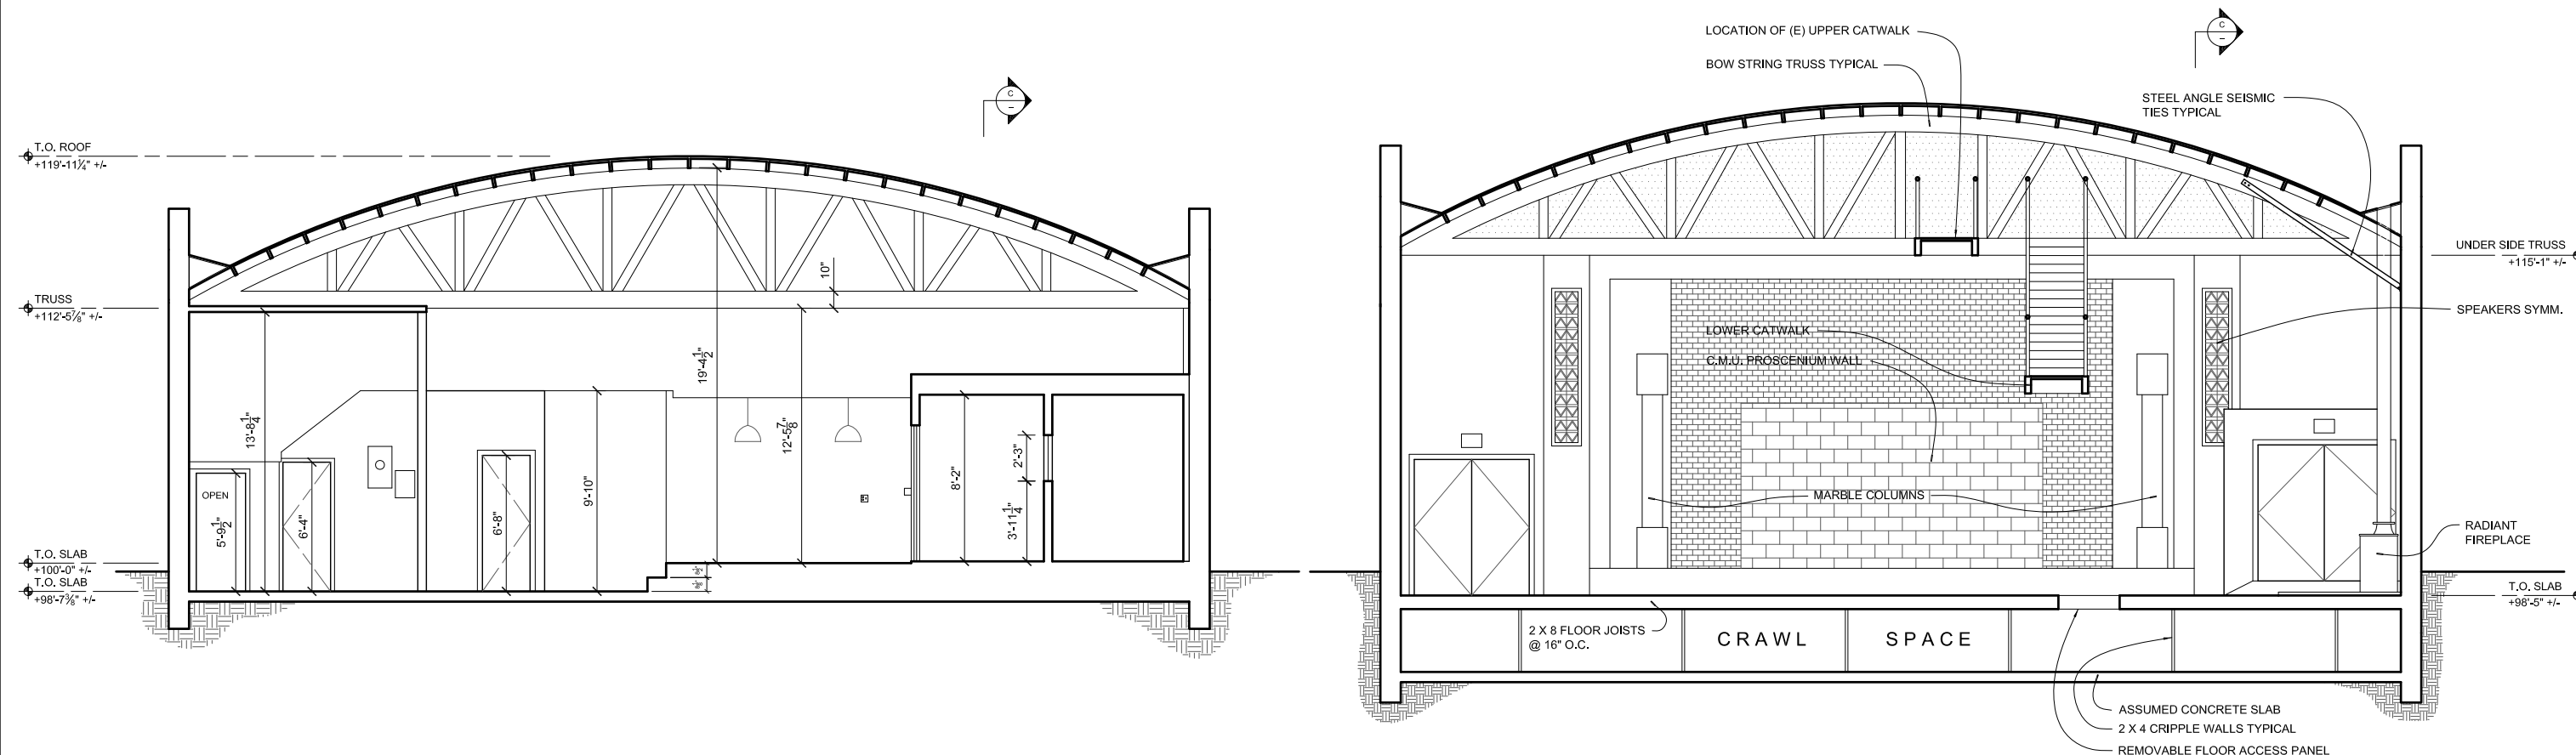

TRANSVERSE SECTION A
Scale: 1/4" = 1'-0"

TRANSVERSE SECTION B
Scale: 1/4" = 1'-0"

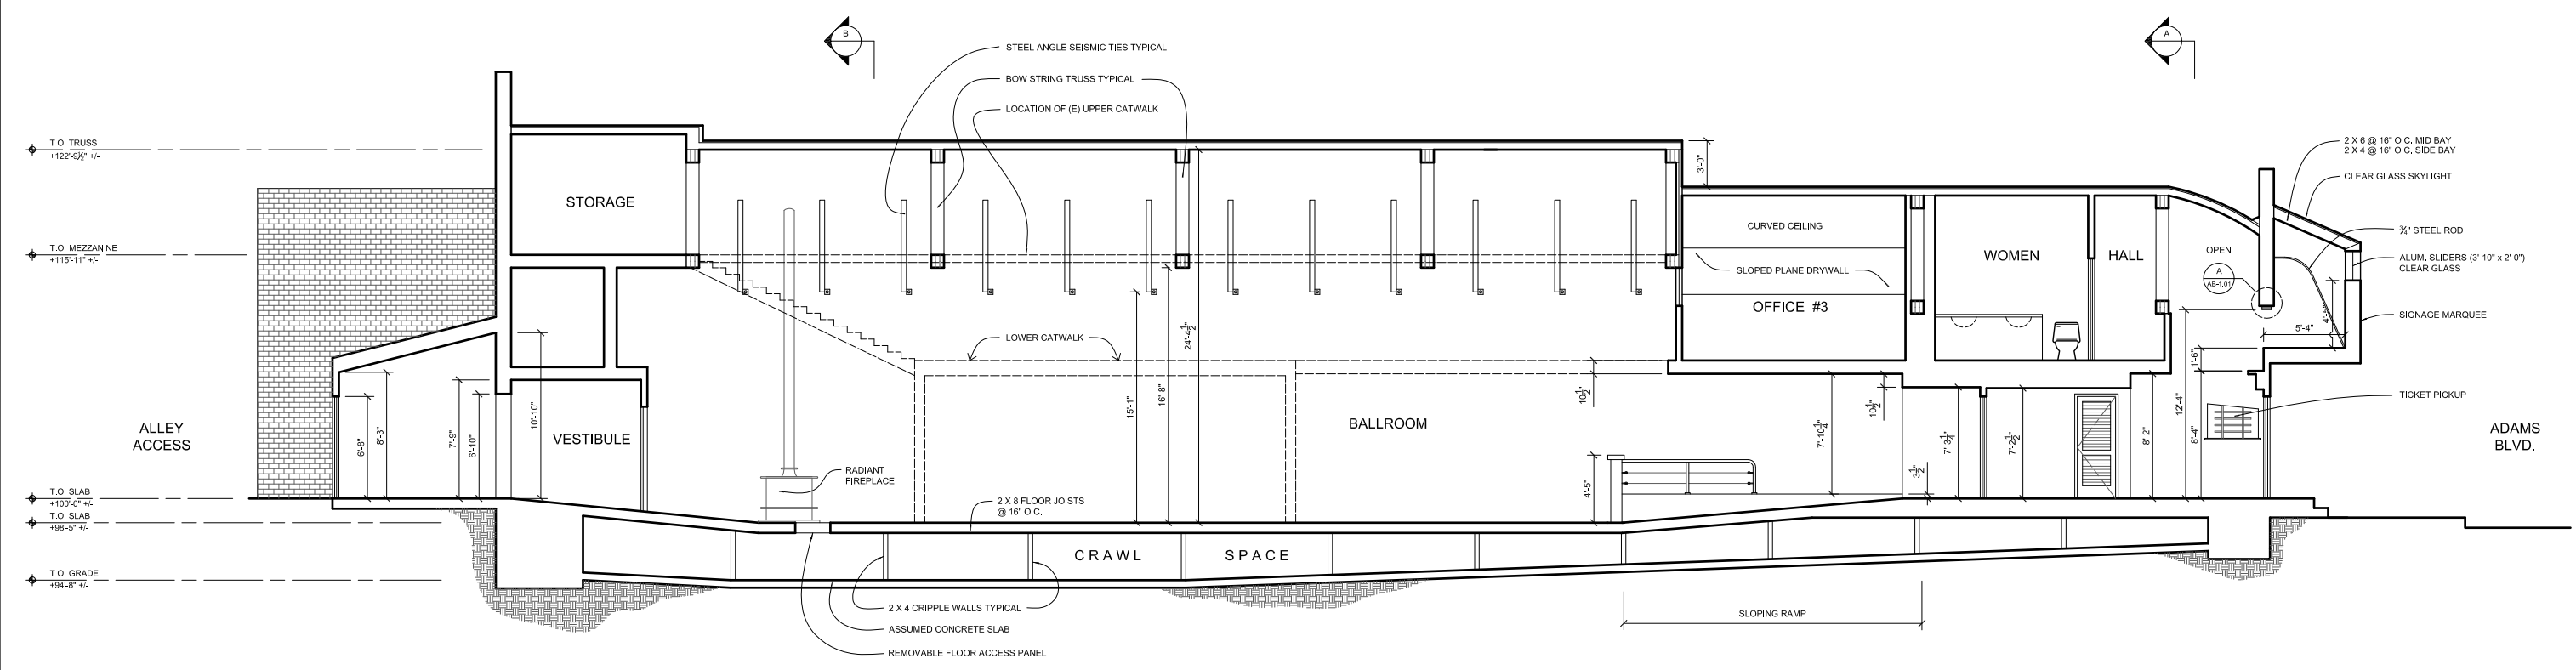

LONGITUDINAL SECTION C
Scale: 3/16" = 1'-0"



REVISIONS	
ALL DESIGNS, ARRANGEMENTS AND PLANS INDICATED OR REPRESENTED BY THIS ARCHITECT OR HIS EMPLOYEES SHALL BE THE PROPERTY OF STUDIO SLAB, INC. AND SHALL REMAIN THE PROPERTY OF STUDIO SLAB, INC. NO PART OF THIS PROJECT, INCLUDING BUT NOT LIMITED TO, THE DESIGN, CONSTRUCTION, OR OPERATION, SHALL BE REPRODUCED OR TRANSMITTED IN ANY FORM OR BY ANY MEANS, ELECTRONIC OR MECHANICAL, INCLUDING PHOTOCOPYING, RECORDING, OR BY ANY INFORMATION STORAGE AND RETRIEVAL SYSTEM, WITHOUT THE WRITTEN PERMISSION OF STUDIO SLAB, INC. SUBCONTRACTORS SHALL VERIFY AND BE RESPONSIBLE FOR ALL DIMENSIONS AND CONDITIONS SHOWN IN THESE DRAWINGS. VARIATIONS FROM THE DIMENSIONS AND CONDITIONS SHOWN IN THESE DRAWINGS SHALL BE THE RESPONSIBILITY OF THE CONTRACTOR.	
OWNER: FAIS DO DO Steven J. Yablok 5257 W. Adams Blvd. Los Angeles, CA 90016 tel (323) 931-4636 x14 fax (323) 935-9989 steven@faisdodo.com	
ARCHITECT: STUDIO SLAB, INC. Martin Roy Mervel 1926 Echo Park Avenue Los Angeles, CA 90026 ph 323 663 8799 fax 323 935 9989 mervel@studioslab.com	
OCTOBER 19, 2006	
AS BUILT	
SECTIONS	
AB-3.01	